


B7-0-FG(1 1:100



T-V-P-0-B7-01



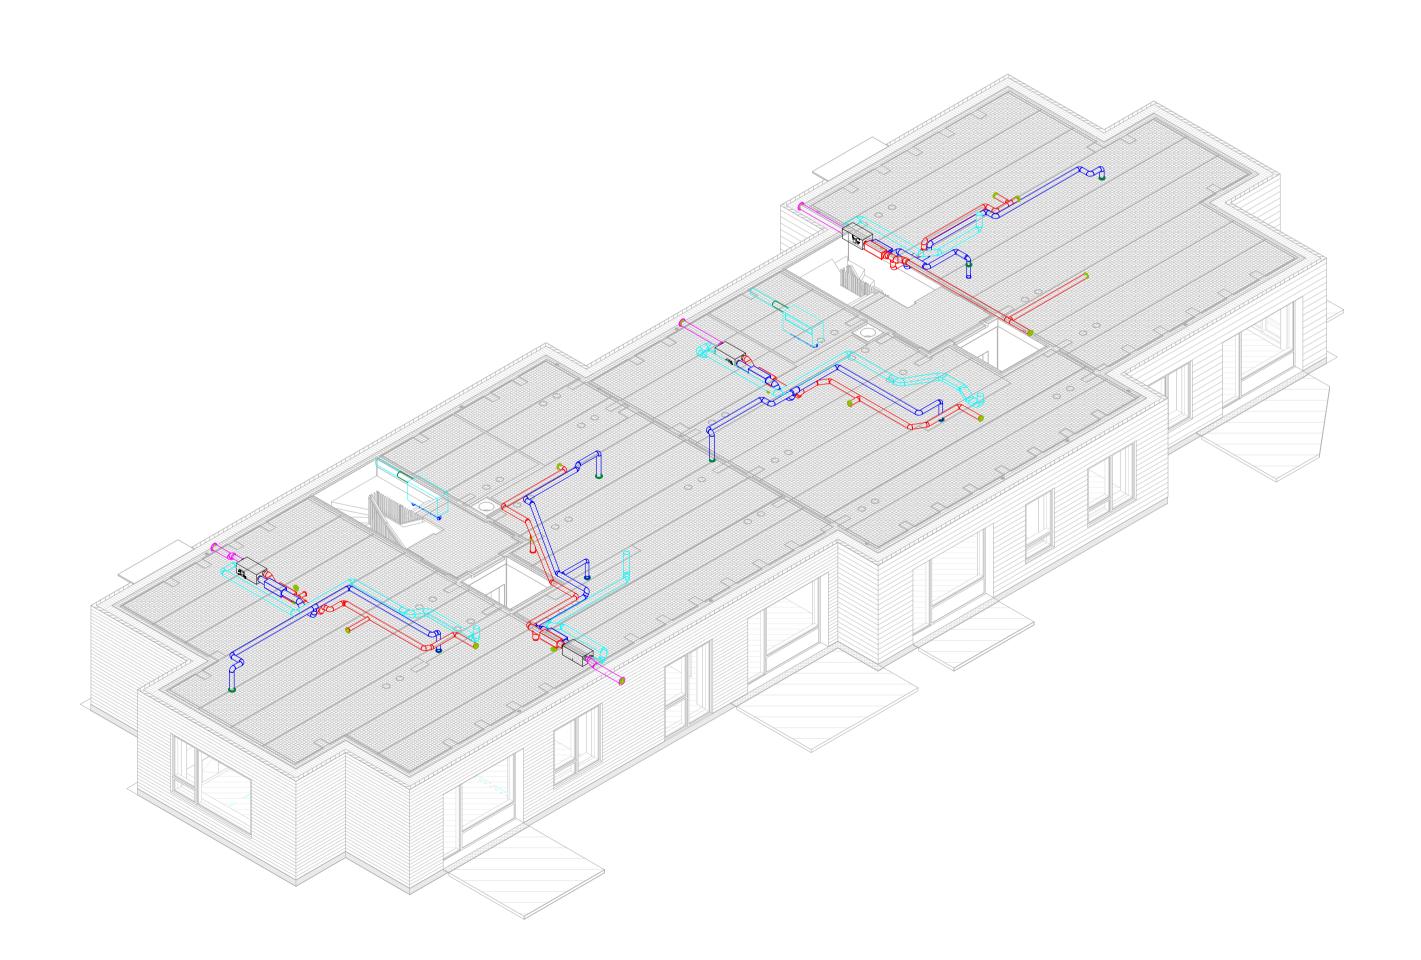

T-V-P-0-B7-01

1:100

tlf: 70203588

TEGNER. AFK

AS BUILT



ANSVARLIG: RLA

8260 Viby J

EMNE:

STUE, PLAN BLOK 7

VENTILATION

DATO: 20-04-17

airteam a/s

REV. DATO:

Gunnar Clausens Vej 34B

<u>B7 - 0</u>