


1 B7-3-FG(1) 1:100




<u>B7 - 3</u>

T-V-P-3-B7-04

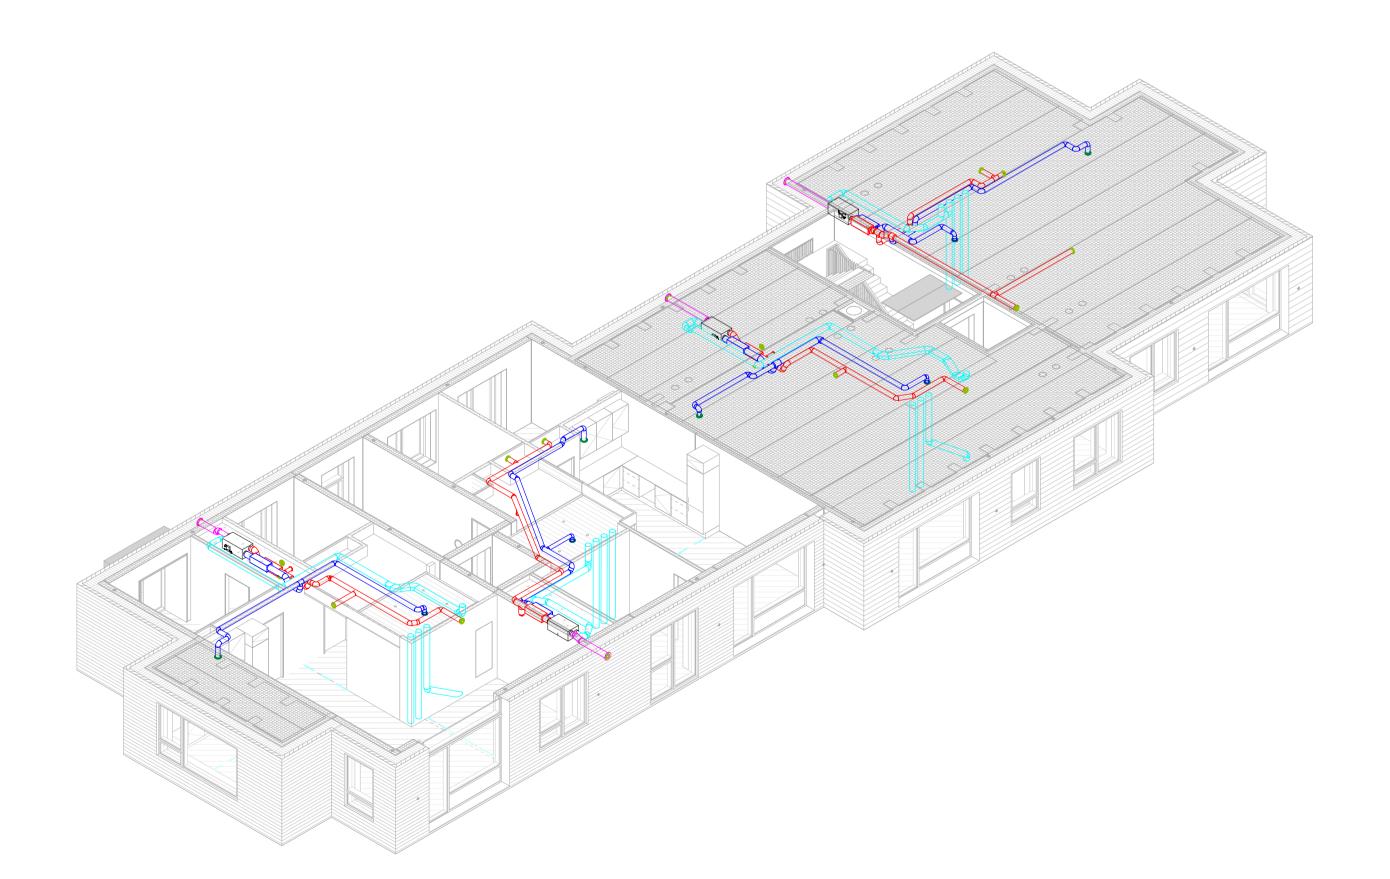



AS BUILT

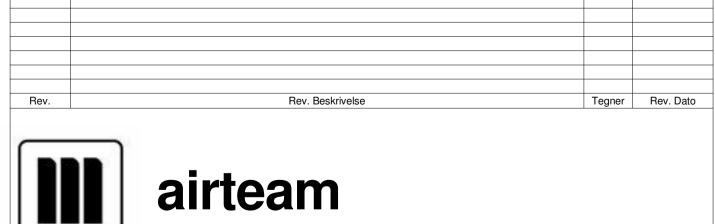

SAGSNAVN:	Frederiks Kaj, etape 1
ADRESSE:	SAGS ADRESSE
SAGS NR:	400663

SAGS NR: 400663

EMNE:

3. ETAGE, PLAN
BLOK 7
VENTILATION

TEGN. NR.
T-V-P-3-B7-04
1:100

DATO: 20-04-17 REV. DATO: ANSVARLIG: RLA TEGNER. AFK

airteam a/s Gunnar Clausens Vej 34B 8260 Viby J tlf: 70203588