



B3-4-FG(1)
1:100



<u>B3 - 4</u>

T-V-P-4-B3-05

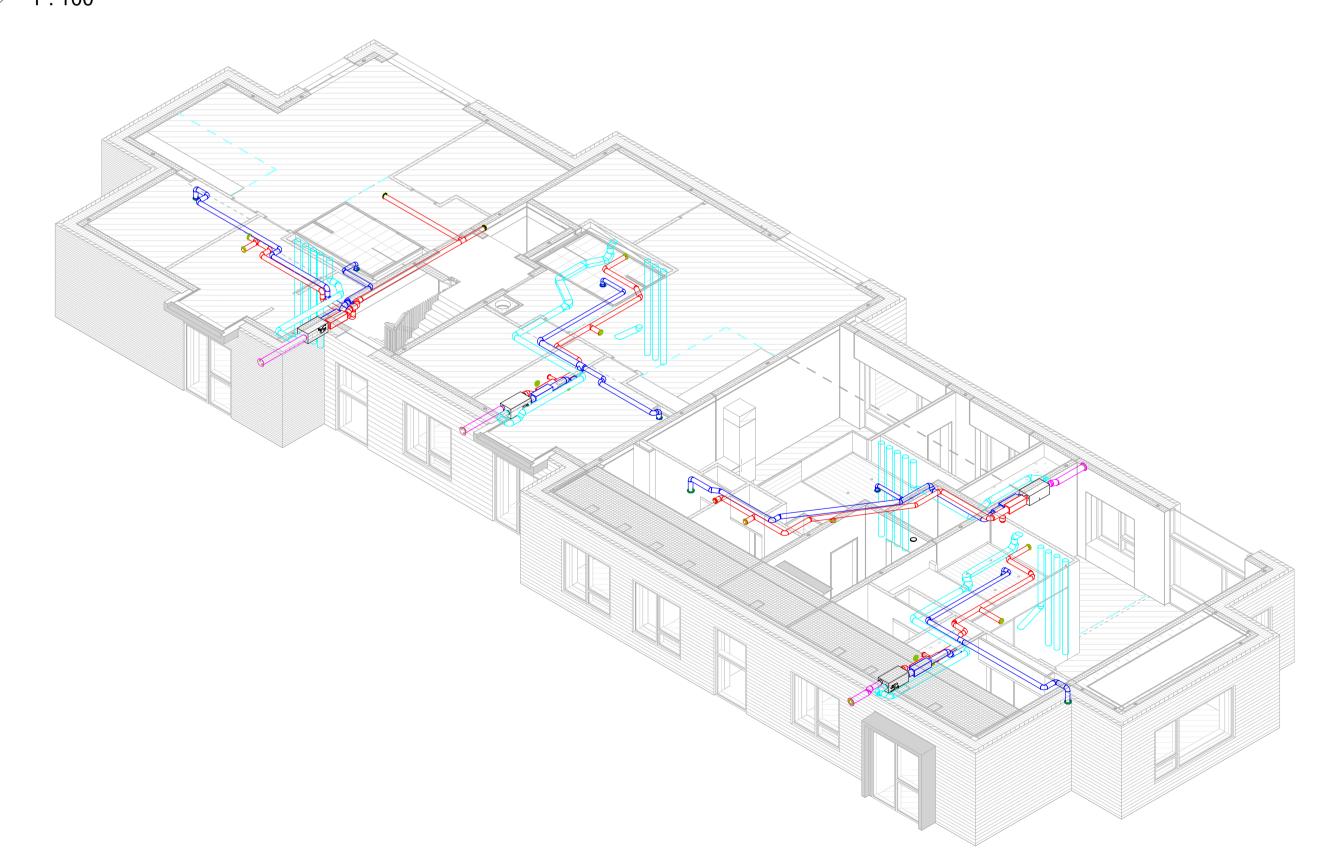

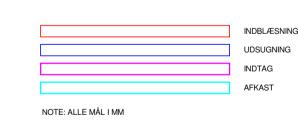

AS BUILT



8260 Viby J

tlf: 70203588

Gunnar Clausens Vej 34B

airteam a/s